


- LEGEND**
- PROPERTY LINE
 - ADJOINING PROPERTY LINE
 - 12" HDPE DRAINAGE PIPE W/ PIPE SIZE
 - 5 FOOT ELEVATION CONTOUR
 - 1 FOOT ELEVATION CONTOUR
 - INLET
 - ⊙ MANHOLE
 - ⊙ SANITARY MANHOLE
 - ⊙ UTILITY MANHOLE
 - CLEANOUT
 - SKID PAD
 - ☆ LIGHT
 - ⊕ FIRE HYDRANT
 - ⚡ SIGN

NOTES

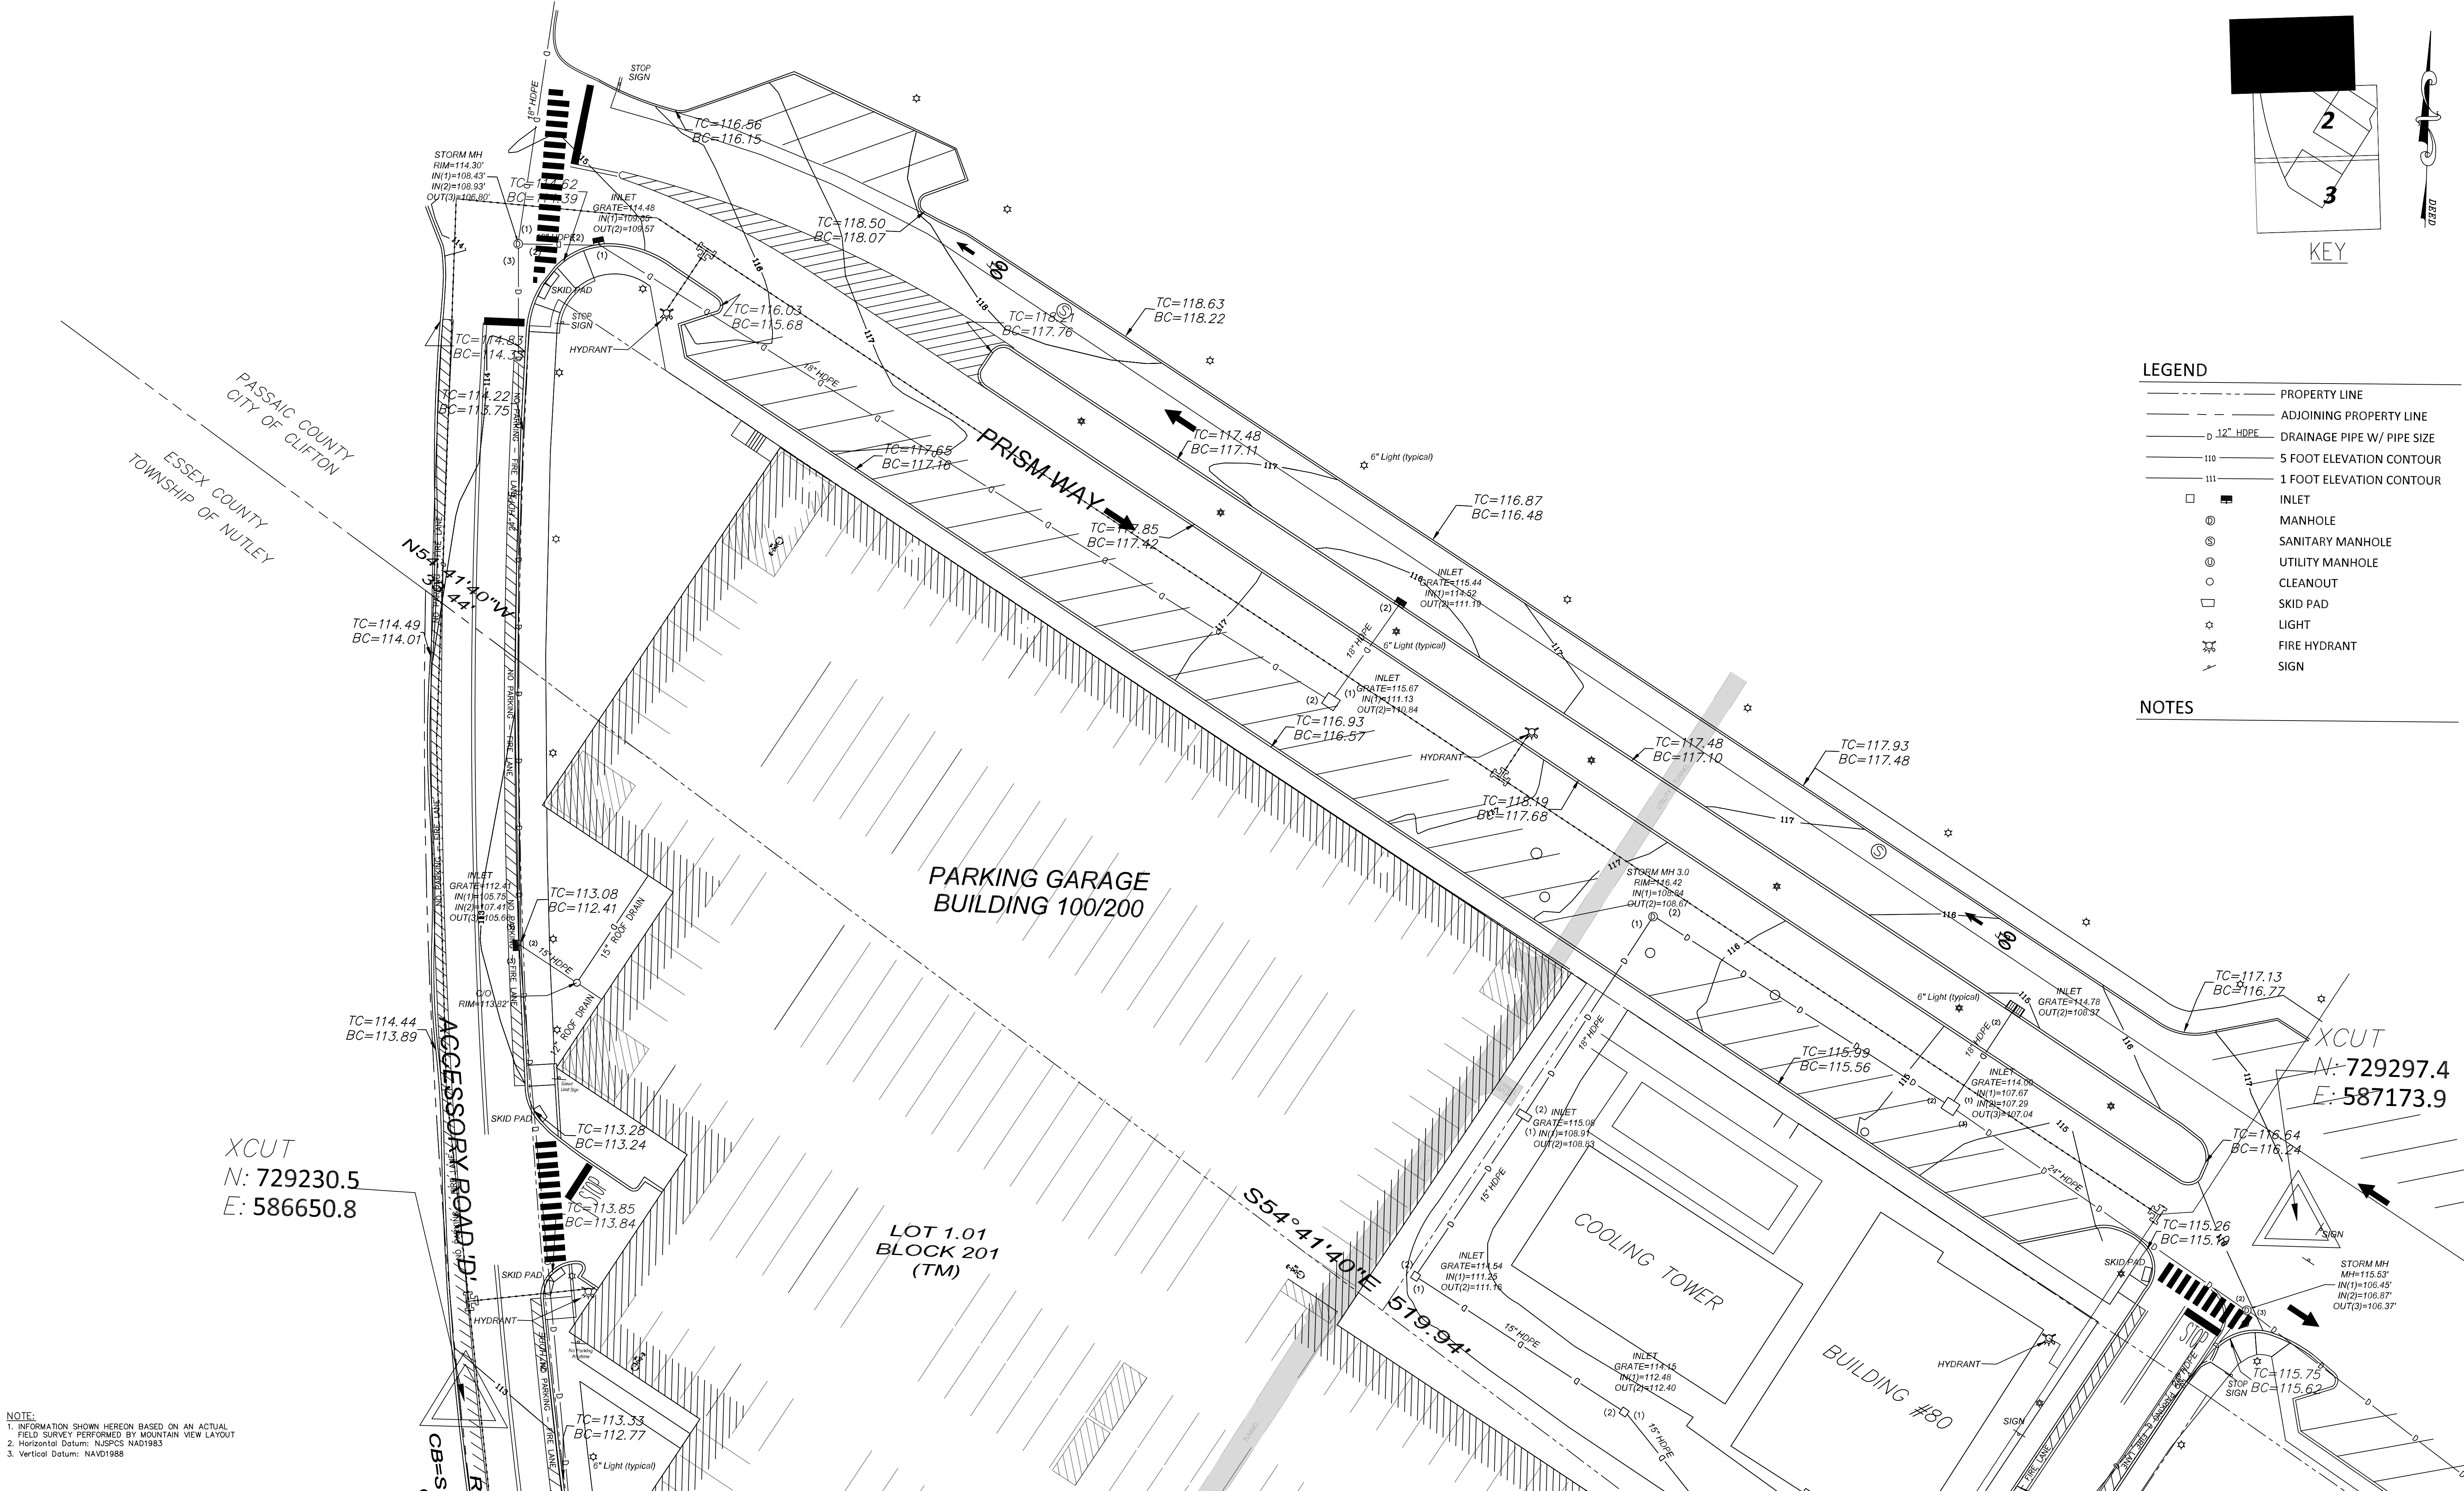

NOTE:
 1. INFORMATION SHOWN HEREON BASED ON AN ACTUAL FIELD SURVEY PERFORMED BY MOUNTAIN VIEW LAYOUT
 2. Horizontal Datum: NAD83
 3. Vertical Datum: NAVD1988

AS BUILT SURVEY
 100/200 PARKING GARAGE & SURROUNDING AREAS
 TOWNSHIP OF NUTLEY, ESSEX COUNTY
 CITY OF CLIFTON, PASSAIC COUNTY
 NEW JERSEY


PROJECT NUMBER MVL2118	FIELD MCB
SCALE 1" = 20'	DRAWN MCB/JSG
DATE 07/13/2021	CHECKED LAA

Mountain View Layout
 Land Surveying & Construction Layout
 Certificate of Authorization #24GA27978900
 www.MountainViewLayout.com
 4 West Main Street - Rockaway, NJ (973) 627-0029
 1025 Lippincott Street - Woodbury, NJ


LUIS ALARCON
 PROFESSIONAL LAND SURVEYOR
Luis A. Alarcon
 LUIS ALARCON N.J.P.L.S LIC. No. 24GS04341000

GRAPHIC SCALE
 1 inch = 20 ft.

1 OF 3

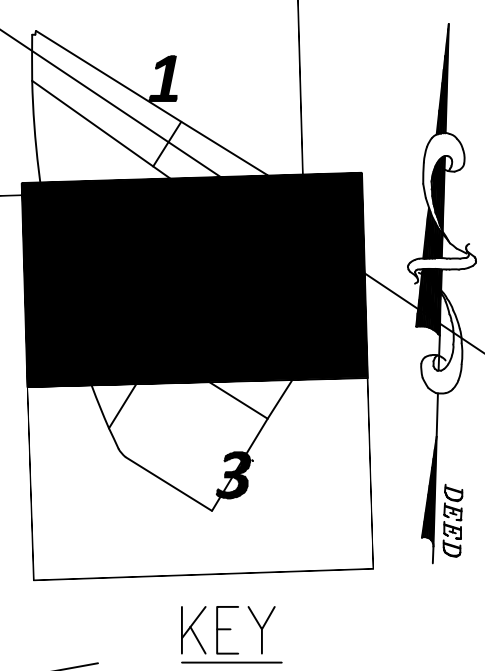

- LEGEND**
- PROPERTY LINE
 - ADJOINING PROPERTY LINE
 - 12" HDPE DRAINAGE PIPE W/ PIPE SIZE
 - 110 5 FOOT ELEVATION CONTOUR
 - 111 1 FOOT ELEVATION CONTOUR
 - INLET
 - MANHOLE
 - SANITARY MANHOLE
 - UTILITY MANHOLE
 - CLEANOUT
 - SKID PAD
 - ★ LIGHT
 - ★ FIRE HYDRANT
 - ★ SIGN

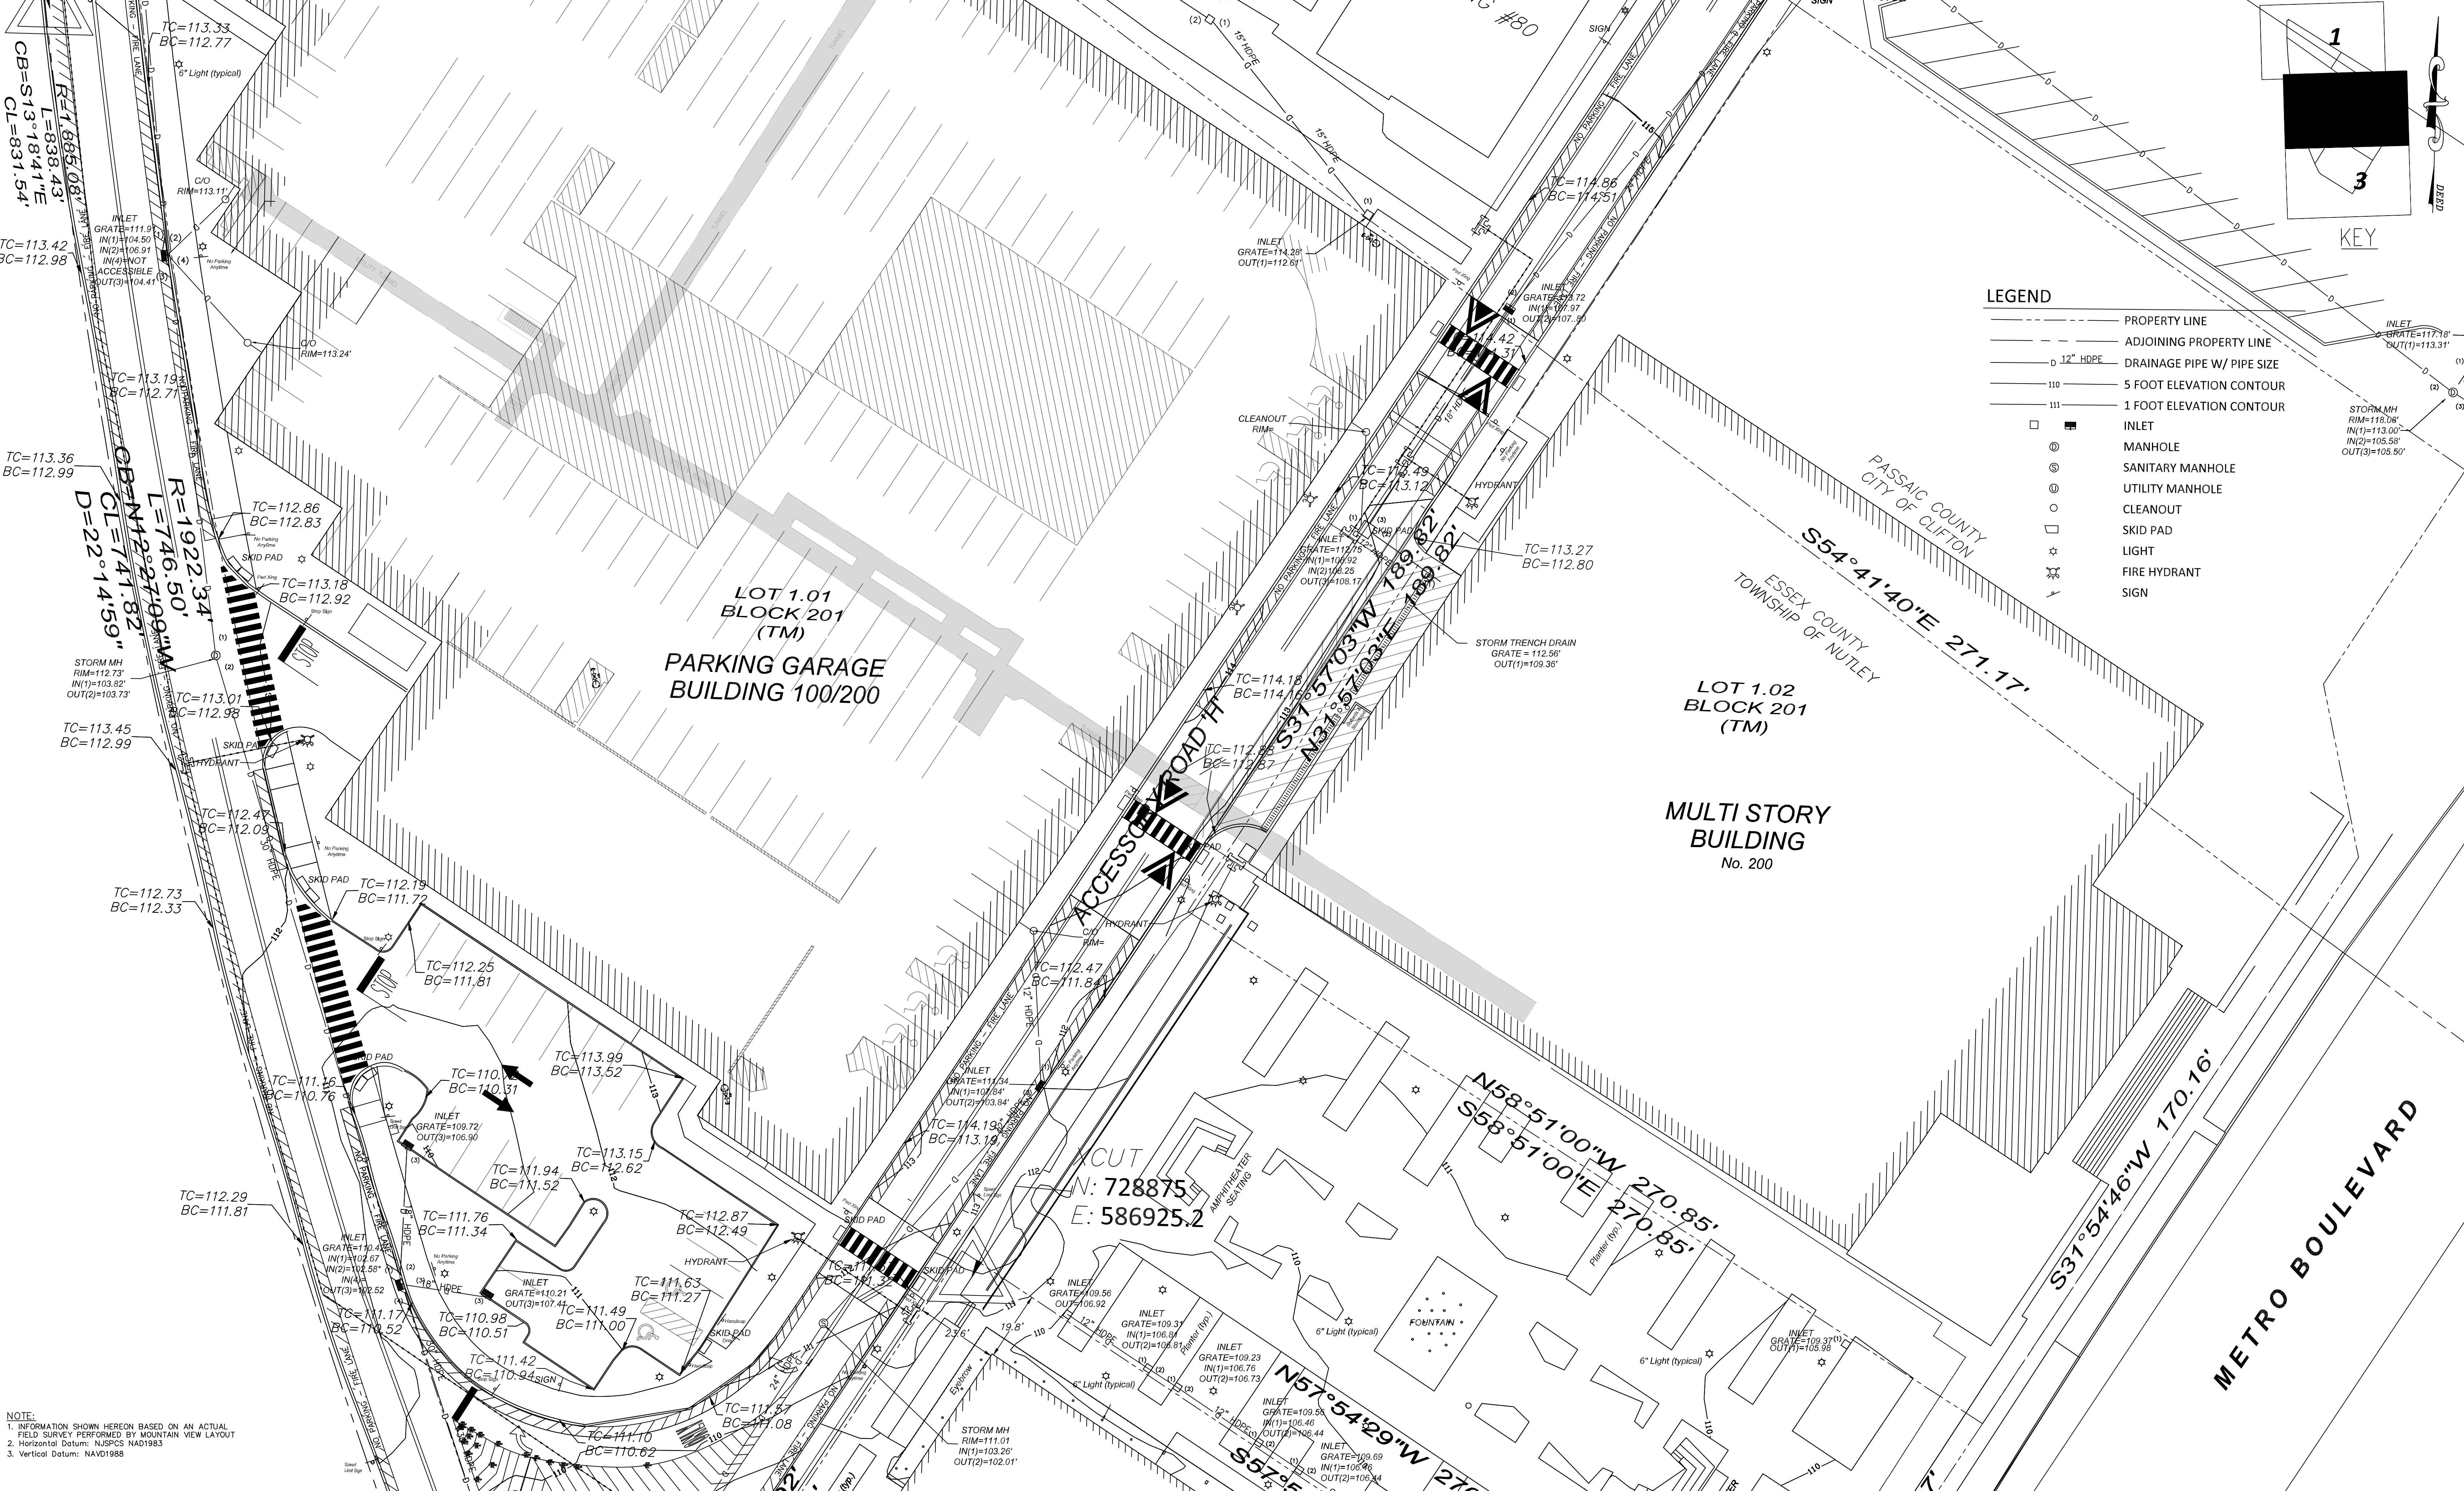

NOTE:
 1. INFORMATION SHOWN HEREON BASED ON AN ACTUAL FIELD SURVEY PERFORMED BY MOUNTAIN VIEW LAYOUT
 2. Horizontal Datum: NAD83
 3. Vertical Datum: NAVD1988



AS BUILT SURVEY
 100/200 PARKING GARAGE & SURROUNDING AREAS
 TOWNSHIP OF NUTLEY, ESSEX COUNTY
 CITY OF CLIFTON, PASSAIC COUNTY
 NEW JERSEY

PROJECT NUMBER MVL2118	FIELD MCB
SCALE 1" = 20'	DRAWN MCB/JSG
DATE 07/13/2021	CHECKED LAA

Mountain View Layout
 Land Surveying & Construction Layout
 Certificate of Authorization #24GA27978900
 www.MountainViewLayout.com
 4 West Main Street - Rockaway, NJ (973) 627-0029
 1025 Lippincott Street - Woodbury, NJ

LUIS ALARCON
 PROFESSIONAL LAND SURVEYOR
Luis Alarcon
 LUIS ALARCON N.J.P.L.S LIC. No. 24GS04341000

GRAPHIC SCALE
 1 inch = 20 ft.

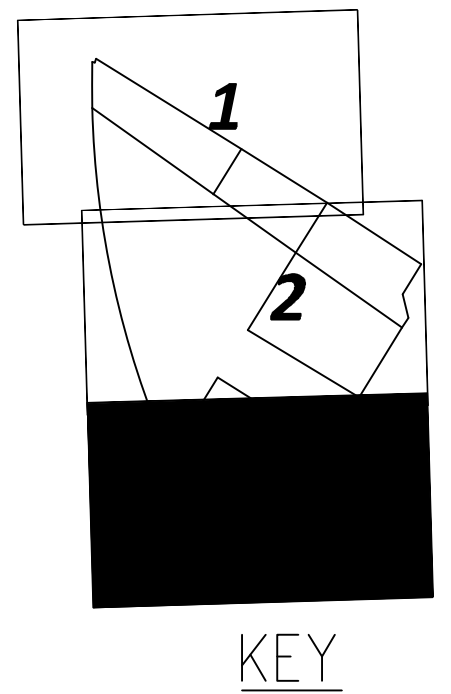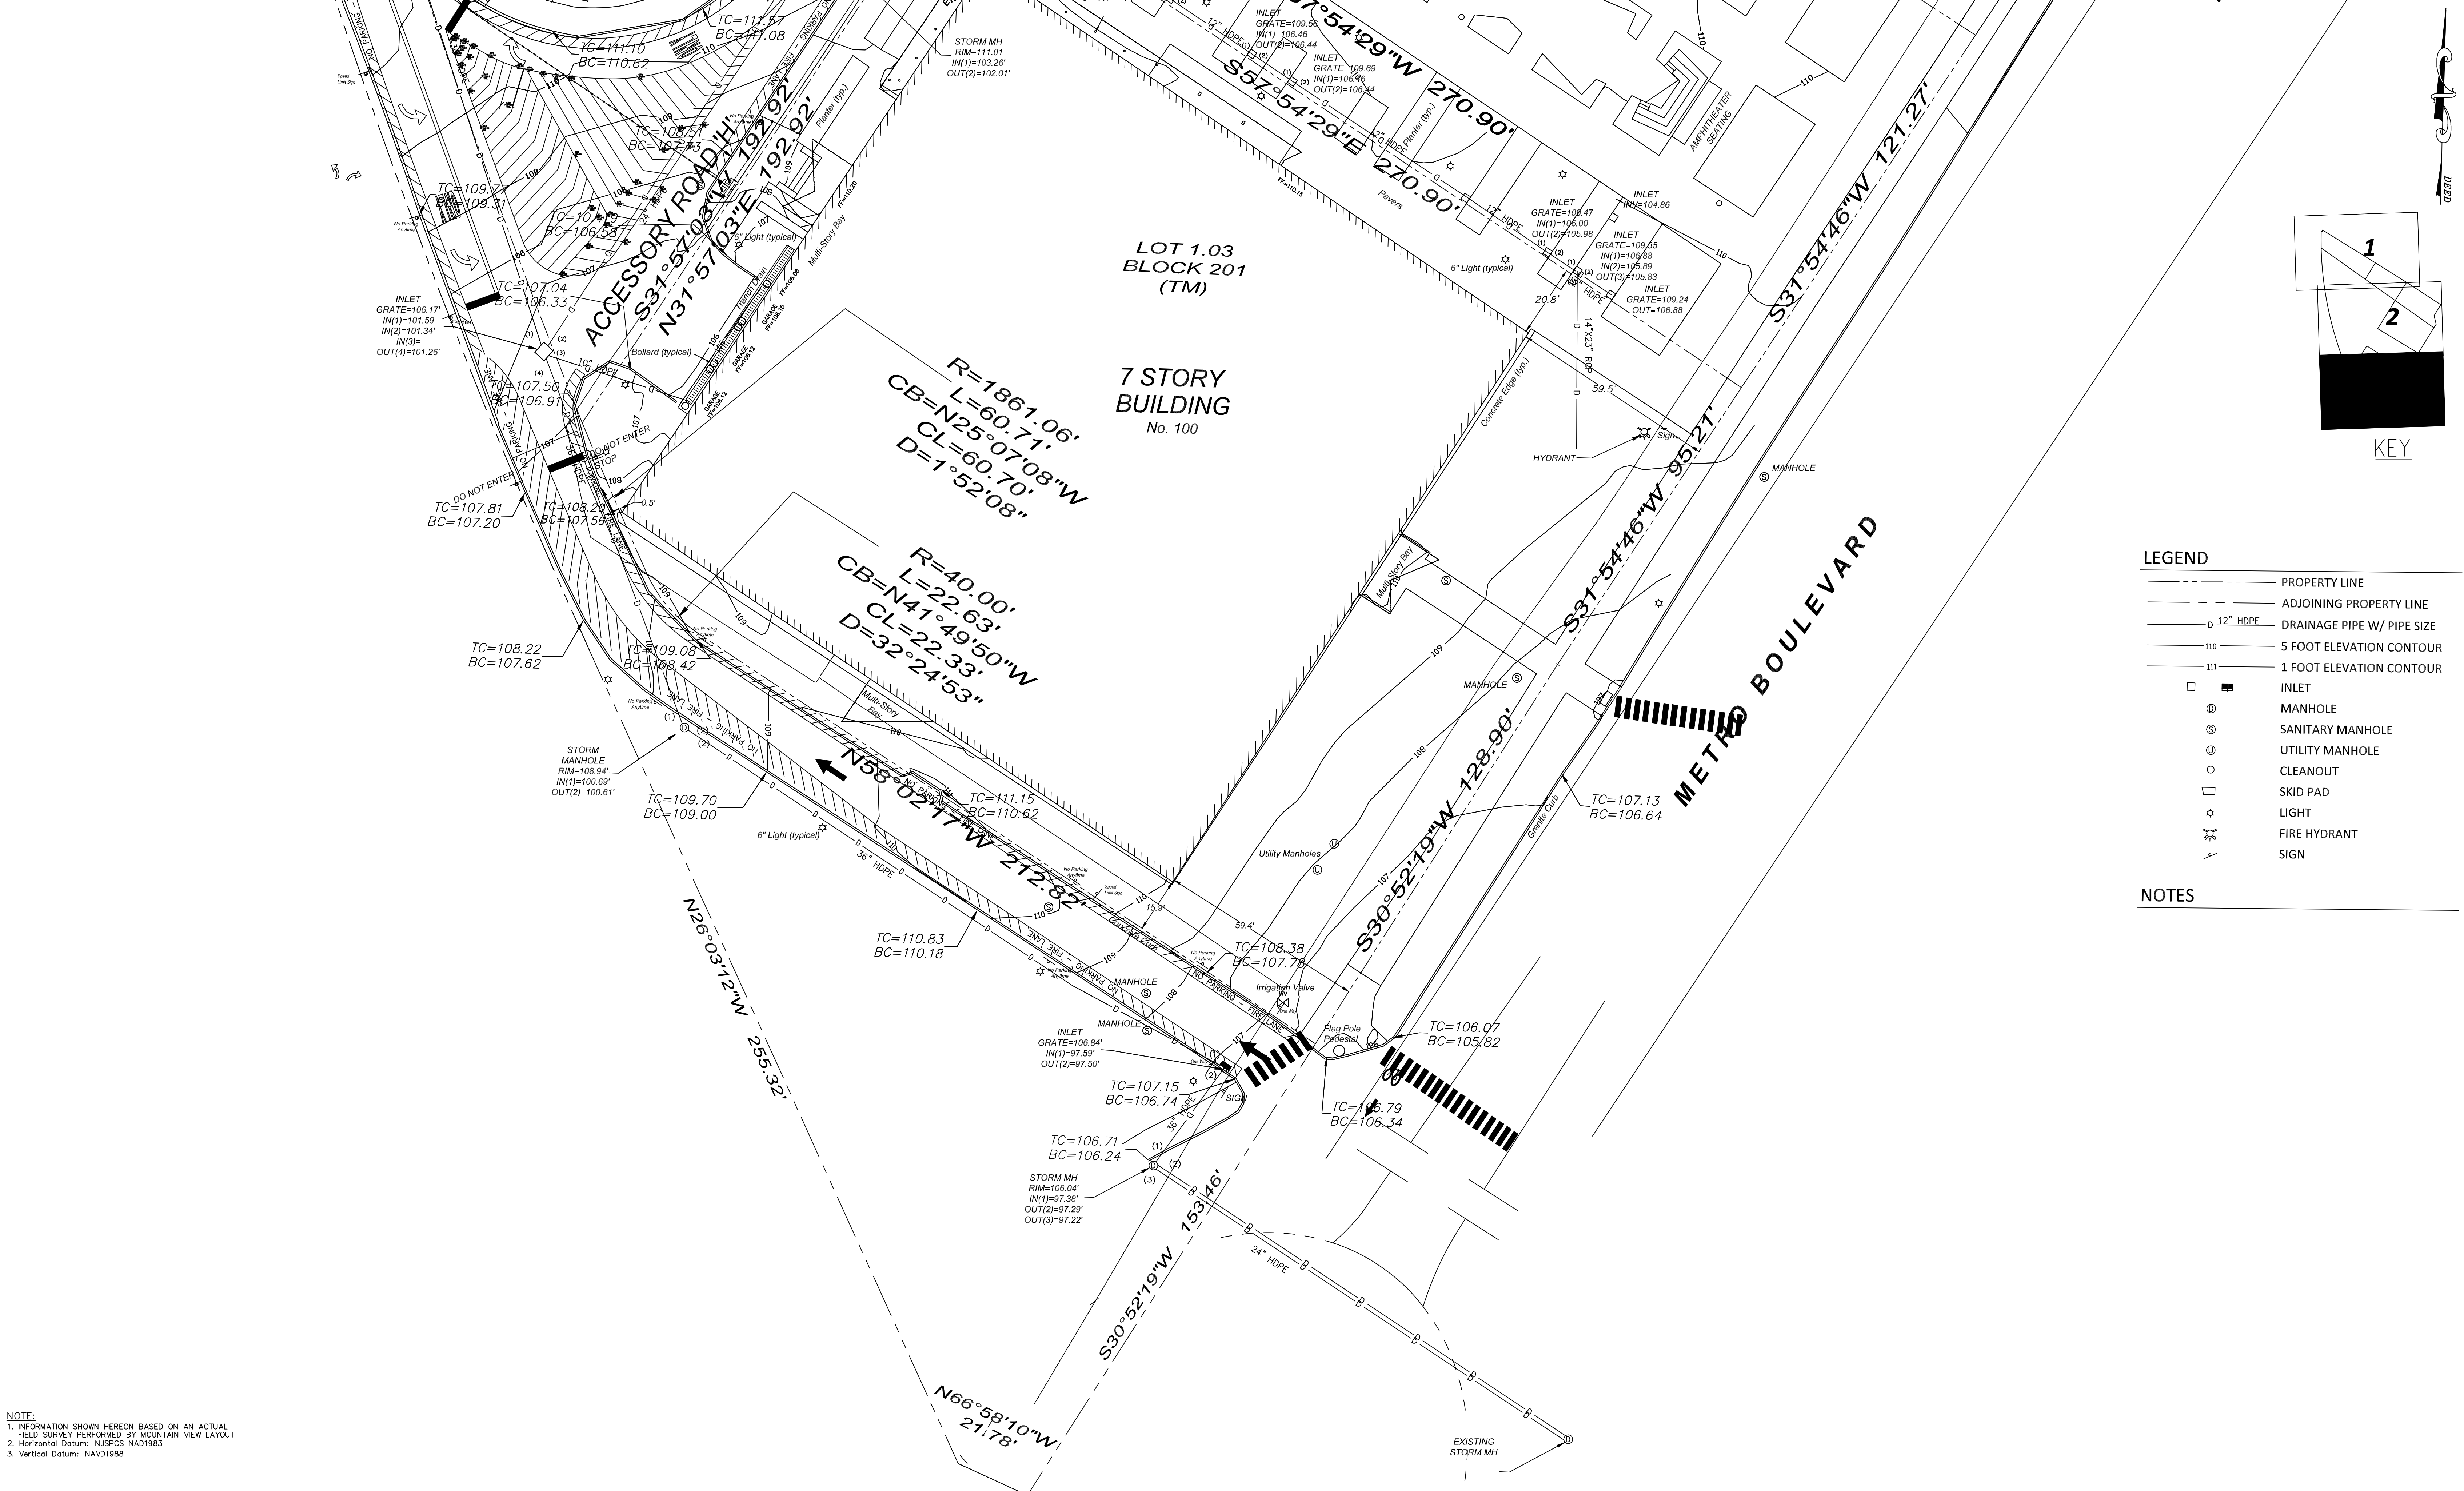

- LEGEND**
- PROPERTY LINE
 - ADJOINING PROPERTY LINE
 - 12" HDPE DRAINAGE PIPE W/ PIPE SIZE
 - 110 5 FOOT ELEVATION CONTOUR
 - 111 1 FOOT ELEVATION CONTOUR
 - INLET
 - ⊙ MANHOLE
 - ⊙ SANITARY MANHOLE
 - ⊙ UTILITY MANHOLE
 - CLEANOUT
 - SKID PAD
 - ☆ LIGHT
 - ☆ FIRE HYDRANT
 - ☆ SIGN

NOTES


NOTE:
 1. INFORMATION SHOWN HEREON BASED ON AN ACTUAL FIELD SURVEY PERFORMED BY MOUNTAIN VIEW LAYOUT
 2. Horizontal Datum: NAD83
 3. Vertical Datum: NAVD1988

AS BUILT SURVEY
 100/200 PARKING GARAGE & SURROUNDING AREAS
 TOWNSHIP OF NUTLEY, ESSEX COUNTY
 CITY OF CLIFTON, PASSAIC COUNTY
 NEW JERSEY

PROJECT NUMBER MVL2118	FIELD MCB
SCALE 1" = 20'	DRAWN MCB/JSG
DATE 07/13/2021	CHECKED LAA

Mountain View Layout
 Land Surveying & Construction Layout
 Certificate of Authorization #24GA27978900
 www.MountainViewLayout.com
 4 West Main Street - Rockaway, NJ (973) 627-0029
 1025 Lippincott Street - Woodbury, NJ

LUIS ALARCON
 PROFESSIONAL LAND SURVEYOR
Luis Alarcon
 LUIS ALARCON N.J.P.L.S LIC. No. 24GS04341000

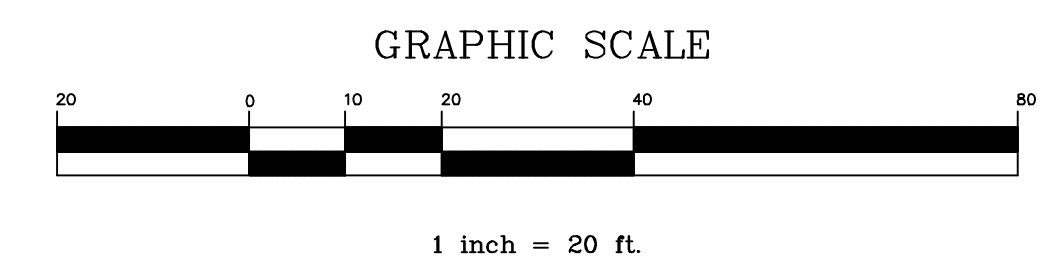

3
 OF
3